



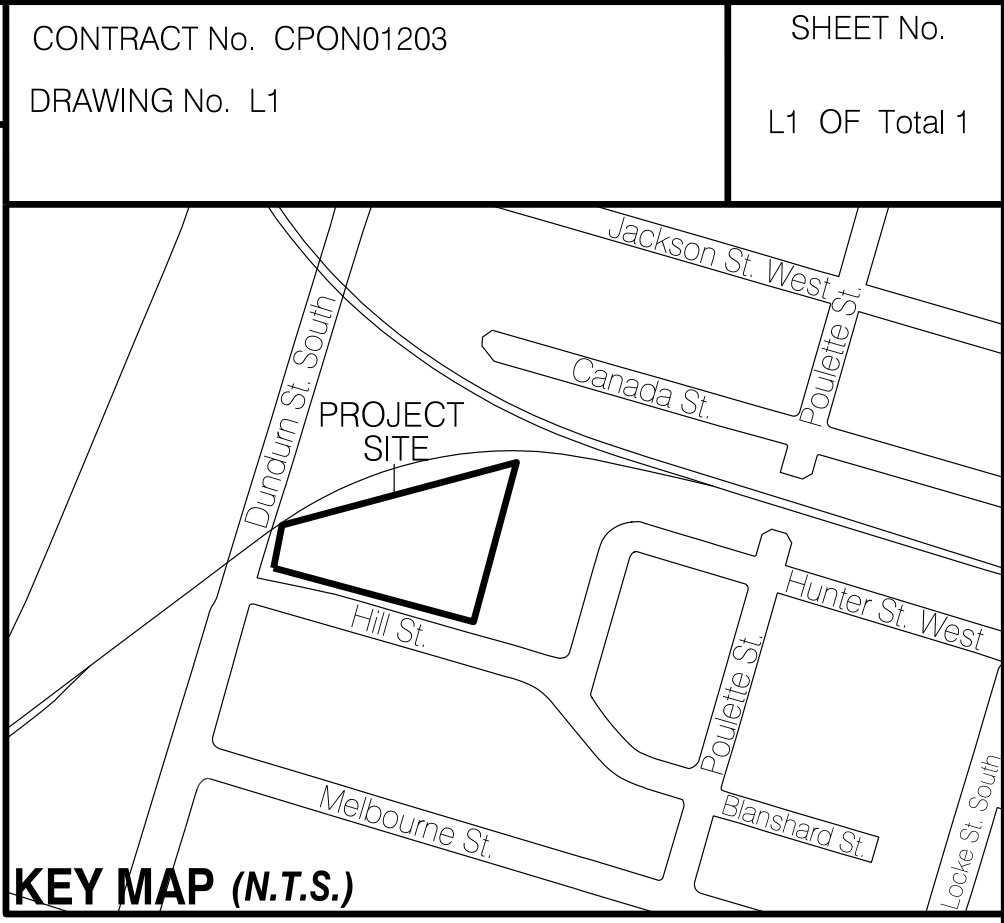

DIMENSIONS SHOWN ON THIS PLAN ARE IN MILLIMETRES UNLESS OTHERWISE NOTED


NOTE:
CONTRACTOR TO REVIEW LAYOUT OF PROJECT ON SITE WITH CITY REPRESENTATIVE PRIOR TO CONSTRUCTION.

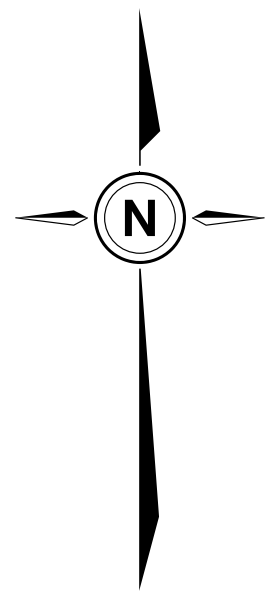

LEGEND

- X — X — X — EXISTING FENCE
- - - - - PROPERTY LINE

No.	REVISIONS	INITIAL	DATE	DRAWN BY: SC	DATE: 08/19/2026
				REFERENCE MATERIAL:	
				Road Plans :	
				Sewer Plans :	
				Water Plans :	
				Regional Surveyor :	
				Geodetic Bench Mark Index No.	
				Elevation=	

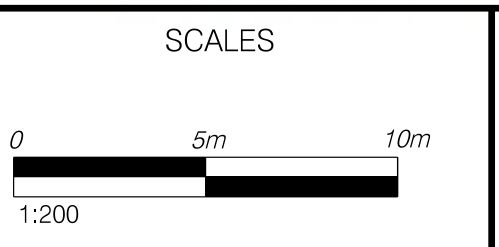

Project Manager, Parks and Cemeteries
Ryan Van Balkom



City of Hamilton
Public Works Department

HILL STREET DOG PARK -
Fence Installation
As-Built